



ACAD Ver 17.1s (LMS Tech)
 User: GAI
 TRB07370 (PL-GRAD.DWG) LAYOUT: Layout1
 11/15/2008 10:00 AM
 3. REFERENCE FILES:
 A:\CY-TRB-PL-BASE\A:\A\BASE\ST-TRB-PL-ENDBASE and N:\STANDARD\44BORDER

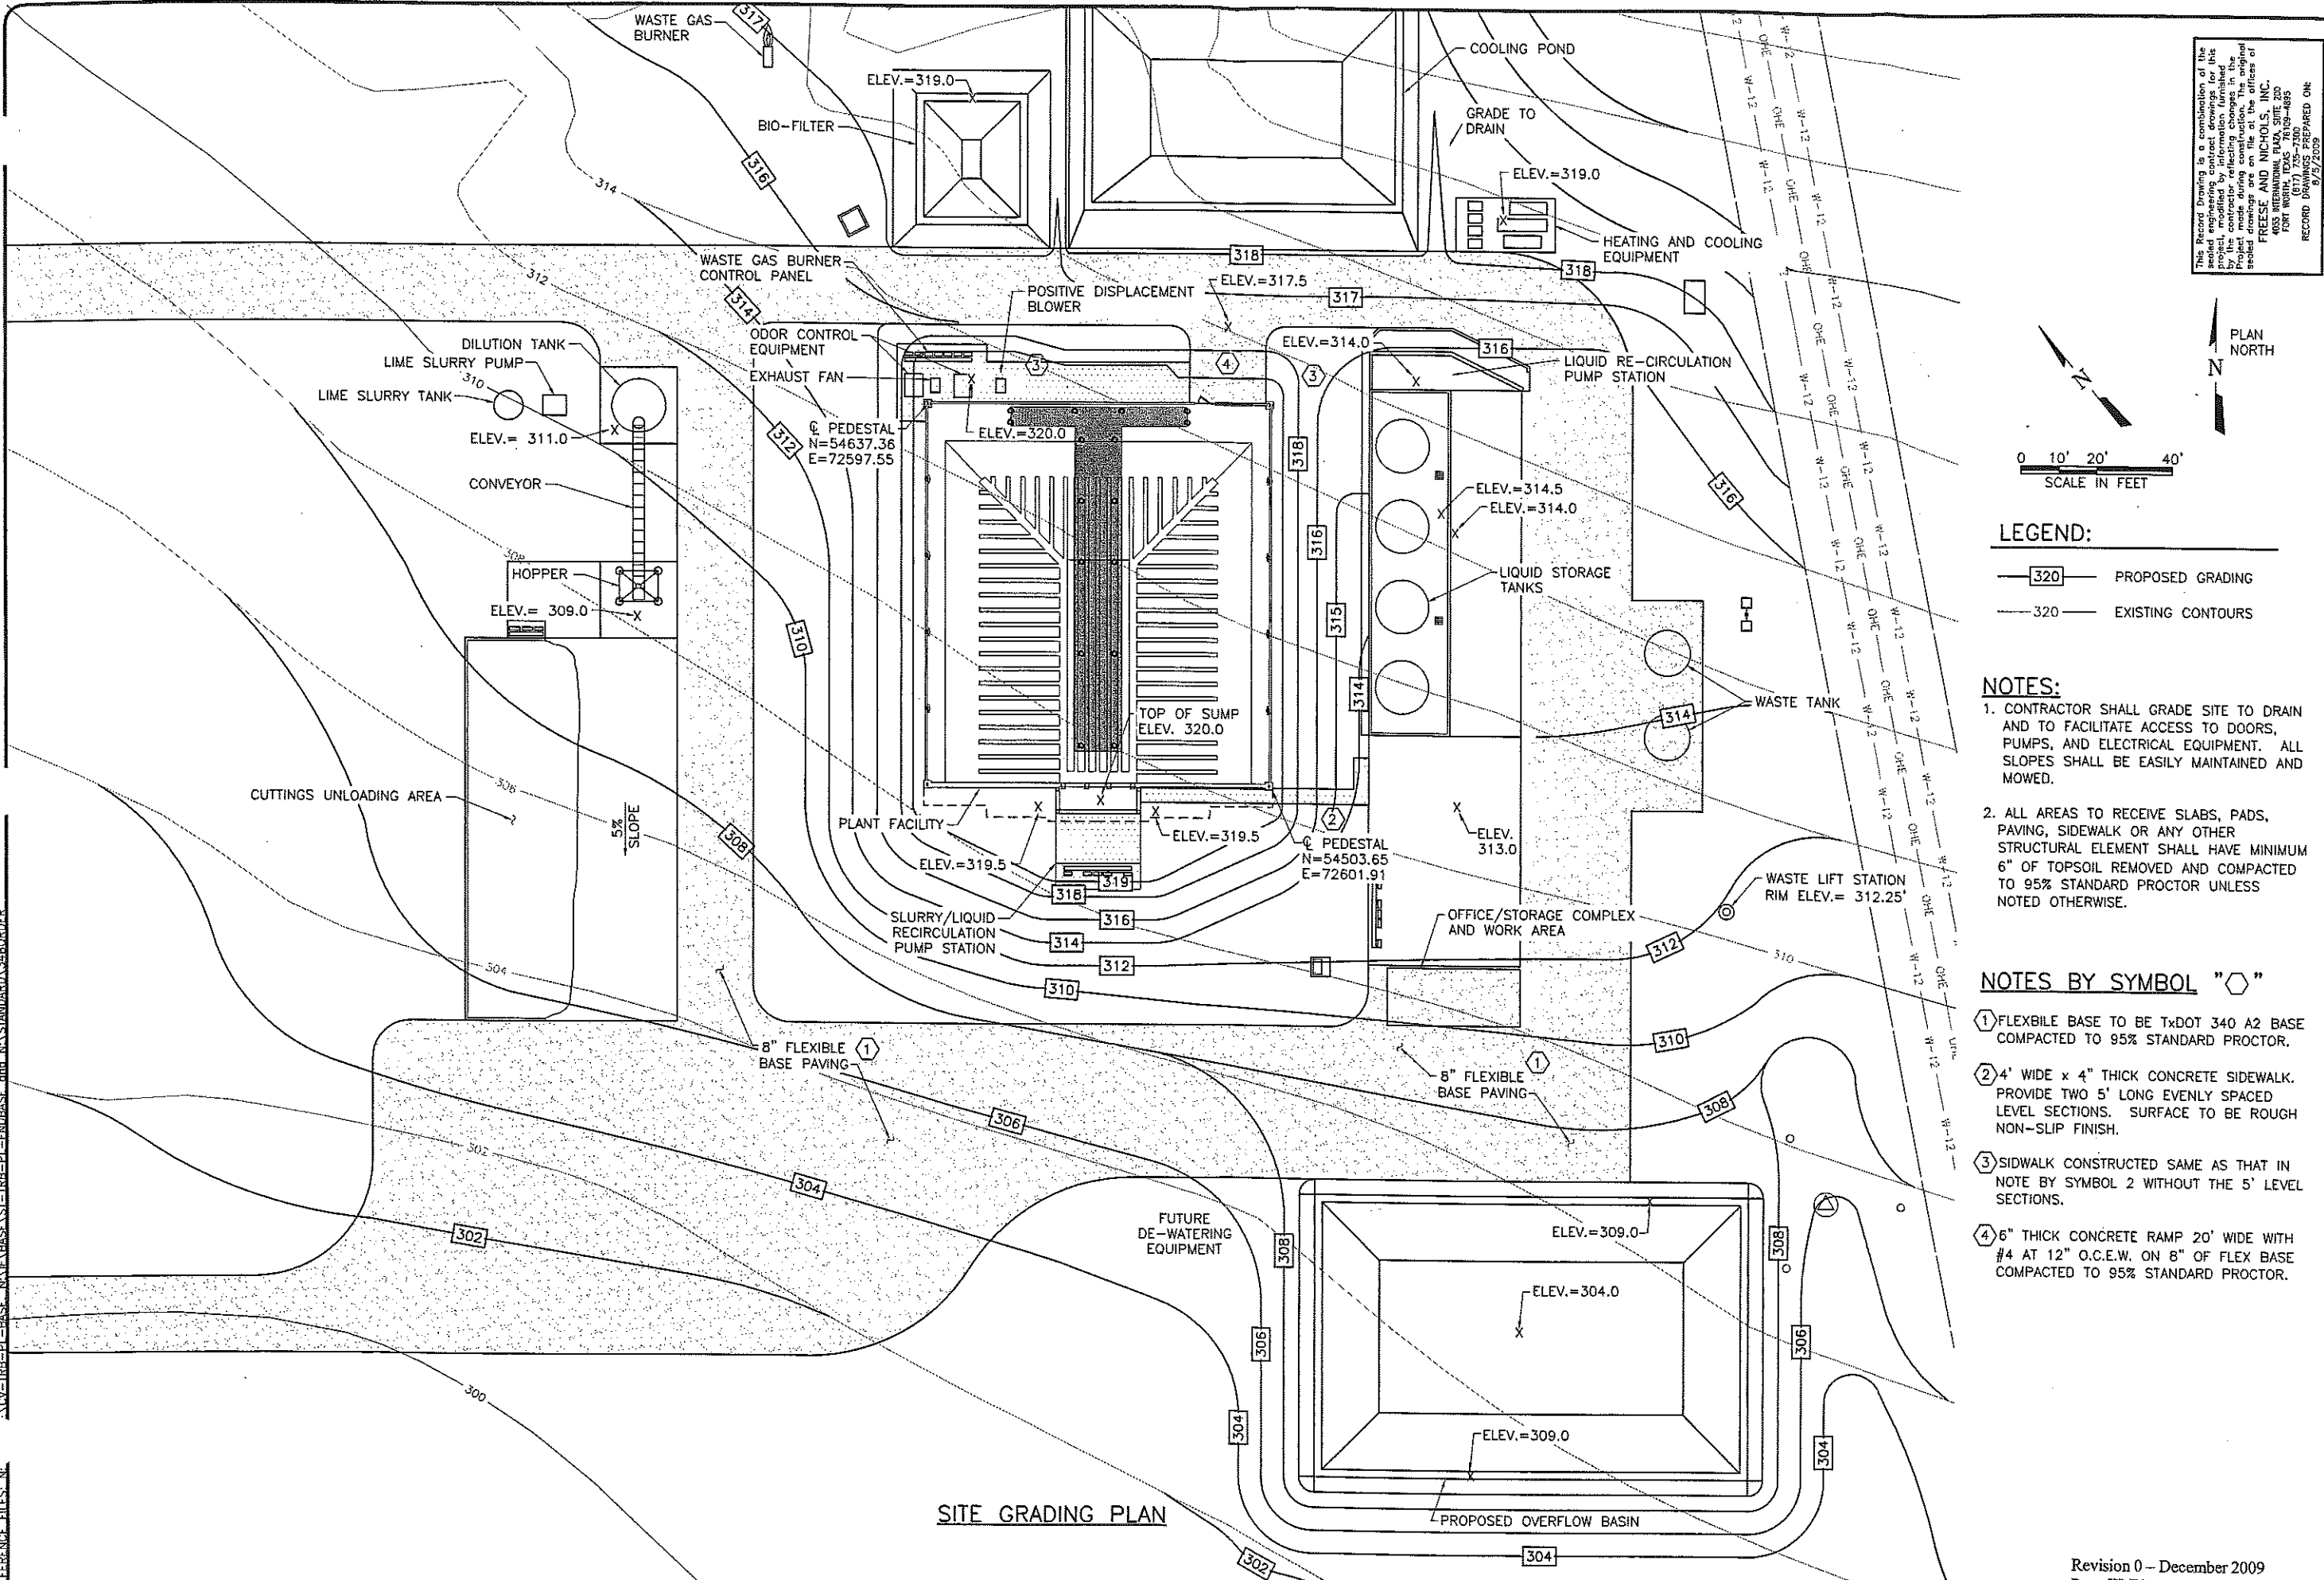

SITE GRADING PLAN

This Record Drawing is a combination of the original information provided for this project, modified by information furnished by the contractor reflecting changes in the project made during construction. The original project was prepared by the offices of FREENE AND NICHOLS, INC., 4053 INTERNATIONAL PLAZA, SUITE 200, FORT WORTH, TEXAS 76109-8855 (817) 759-7300 RECORD DRAWING PREPARED ON: 8/27/2009

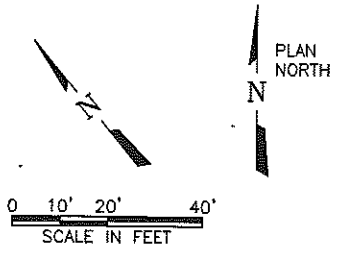

LEGEND:


- 320 — PROPOSED GRADING
- 320 — EXISTING CONTOURS

NOTES:

1. CONTRACTOR SHALL GRADE SITE TO DRAIN AND TO FACILITATE ACCESS TO DOORS, PUMPS, AND ELECTRICAL EQUIPMENT. ALL SLOPES SHALL BE EASILY MAINTAINED AND MOWED.
2. ALL AREAS TO RECEIVE SLABS, PADS, PAVING, SIDEWALK OR ANY OTHER STRUCTURAL ELEMENT SHALL HAVE MINIMUM 6" OF TOPSOIL REMOVED AND COMPACTED TO 95% STANDARD PROCTOR UNLESS NOTED OTHERWISE.

NOTES BY SYMBOL "⬡"

- 1 FLEXIBLE BASE TO BE TxDOT 340 A2 BASE COMPACTED TO 95% STANDARD PROCTOR.
- 2 4' WIDE x 4" THICK CONCRETE SIDEWALK. PROVIDE TWO 5' LONG EVENLY SPACED LEVEL SECTIONS. SURFACE TO BE ROUGH NON-SLIP FINISH.
- 3 SIDEWALK CONSTRUCTED SAME AS THAT IN NOTE BY SYMBOL 2 WITHOUT THE 5' LEVEL SECTIONS.
- 4 6" THICK CONCRETE RAMP 20' WIDE WITH #4 AT 12" O.C.E.W. ON 8" OF FLEX BASE COMPACTED TO 95% STANDARD PROCTOR.

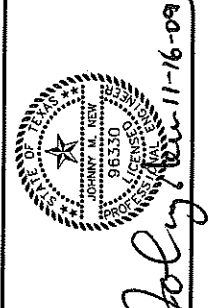

FREENE AND NICHOLS
 4040 Broadway Street, Suite 800
 San Antonio, Texas 78209-6350
 Phone - (210) 296-3600
 Fax - (210) 296-3601

TERRABON, LLC
MIX ALCO BIOMASS PILOTATION FACILITY
 SITE GRADING PLAN - SOUTH

NO. / ISSUE	DATE	BY	CHKD.	FILE NAME
TRB07370	MAY 2008	JIM	JIM	CY-TRB-PL-GRAD02.dwg
DESIGNED	DATE	BY	CHKD.	
REVISION	DATE	BY	CHKD.	
REVISED	DATE	BY	CHKD.	

Bar is one inch on original drawing. If not one inch on this sheet, adjust scale.

VERIFY SCALE

SHEET **C-2A**

SEQ.