



ALCAD Ref 1/11s (LWS, lscb) User: GAL
 [TRB07370] [AUSTIN] [N:\P\DRAWINGS\CY-TRB-PL-DETAIL02.DWG LAYOUT: Layout1
 APR 22, 2008 11:11 AM LTS: 1.00 PSLTS: 1 TWIST: 0.0
 REFERENCE FILE: N:\ST
 3480RDR

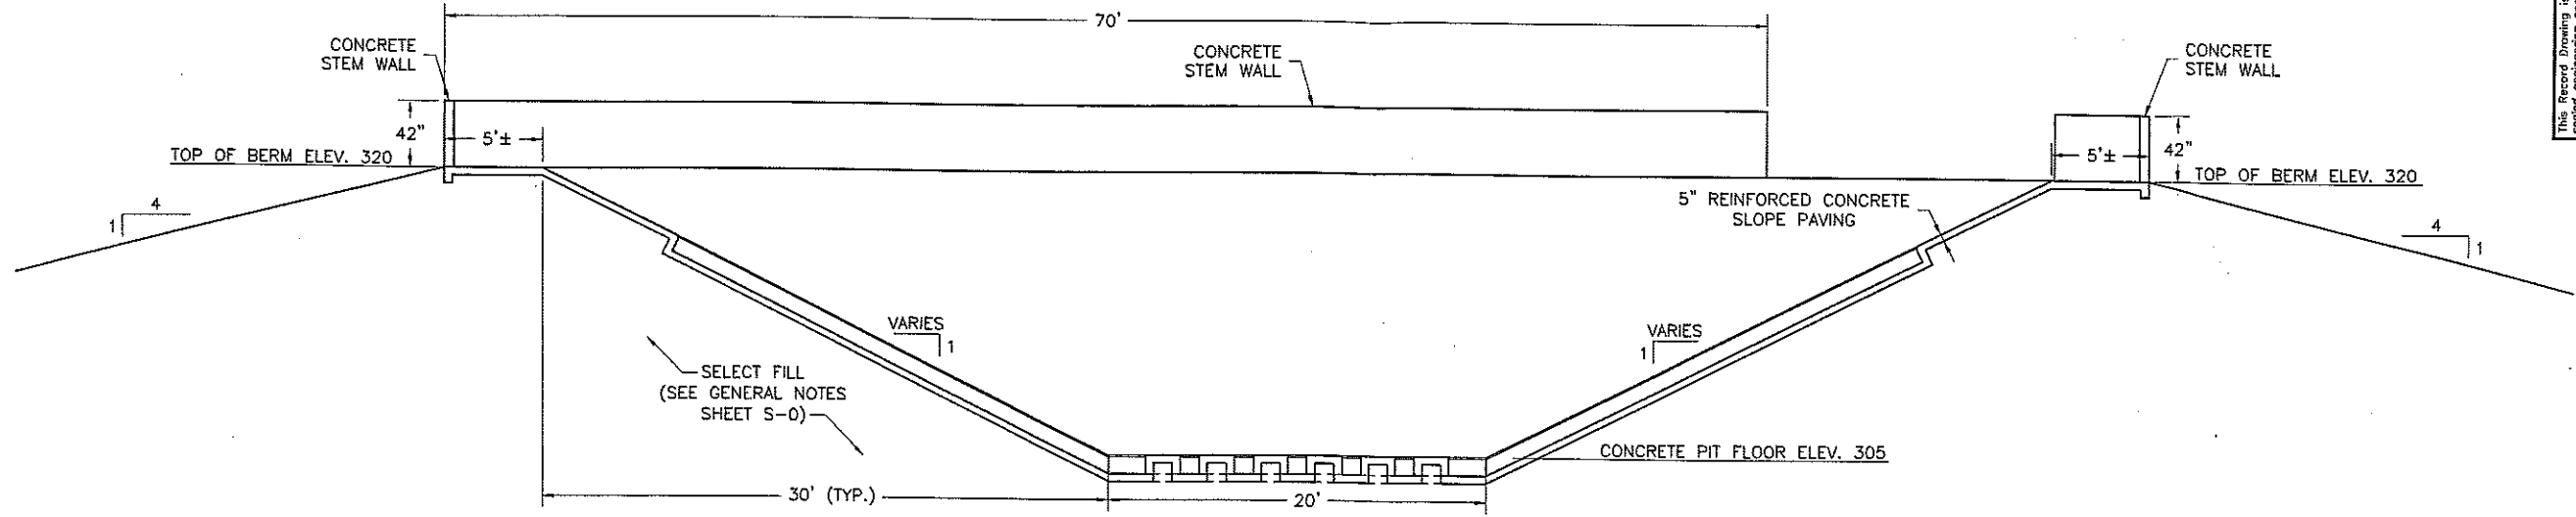

CROSS SECTION VIEW
 A
 P-1/P-3
 0 5' 10'
 SCALE IN FEET

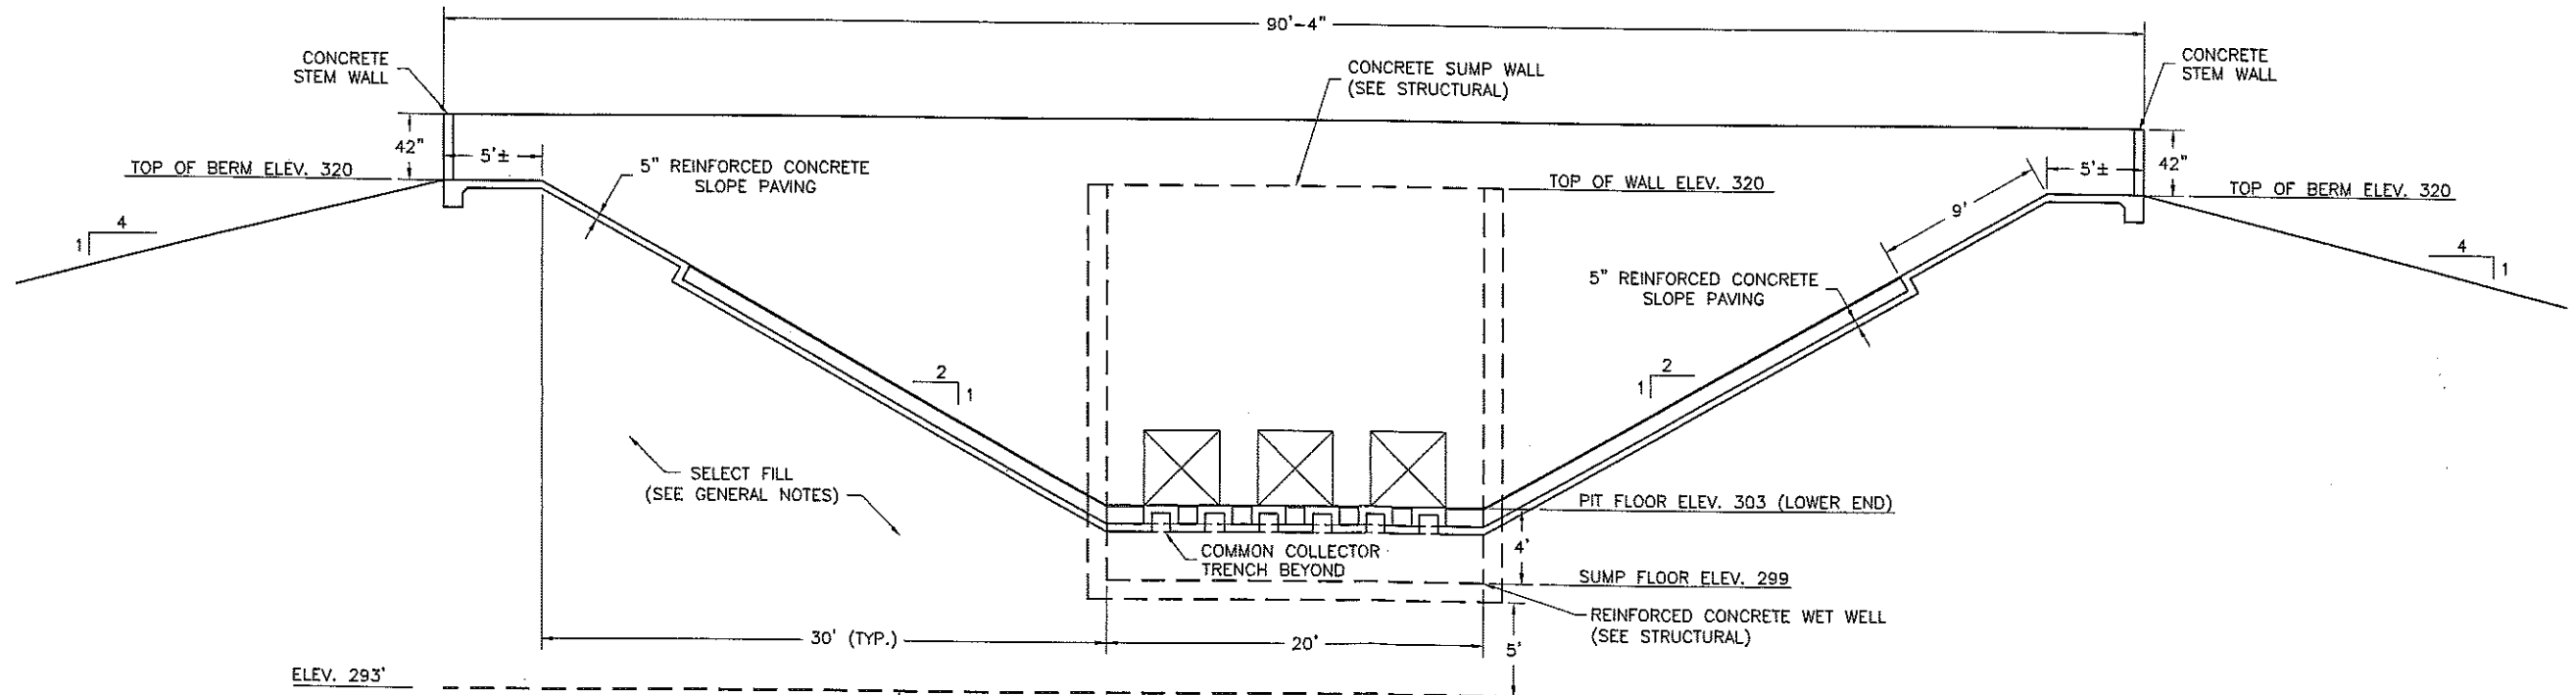

CROSS SECTION VIEW
 B
 P-1/P-3
 0 5' 10'
 SCALE IN FEET

This Record Drawing is a representation of the sealed engineering contract drawings for this project, modified by information furnished by the contractor, reflecting changes in the sealed drawings and any other changes. The original sealed drawings are on file at the office of
FREESSE AND NICHOLS, INC.
 4005 INTERNATIONAL PLAZA, SUITE 200
 FORT WORTH, TEXAS 76109-4885
 (817) 733-2800
 RECORD DRAWINGS PREPARED ON: 8/5/2009

FREESSE AND NICHOLS
 4040 Broadway Street, Suite 800
 Fort Worth, Texas 76109-6330
 Phone - (214) 298-3301
 Fax - (214) 298-3301

July Rev 11-16-09

TERRABON, LLC
MIX ALCO BIOMASS PILOSTRATION FACILITY
PLANT FACILITY
CROSS SECTIONS

NO.	ISSUE	DATE	BY	DATE	TRB JOB NO.	DATE	DESIGNED	BRN	REVIEWED	FILE NAME
					TRB07370	MAY 2008	TBV	CTP	CTP	CY-TRB-PL-DETAIL02.dwg

Bar is one inch on original drawing, not one inch on this sheet, adjust scale.

VERIFY SCALE

SHEET **P-3**

SEC.