


User: CA
 (TRB07370) (AUSTIN) (NA) (P) (A) (WINGS) (CV) (TRB) (DT) (MISC02) (DWG) (LAYOUT) (Layout1)
 NOV 05 2007 10:42
 LTS: 1.00 PSLTS: 0 TWIST: 0.0
 REFERENCE FILE: NA STA 348BORDER

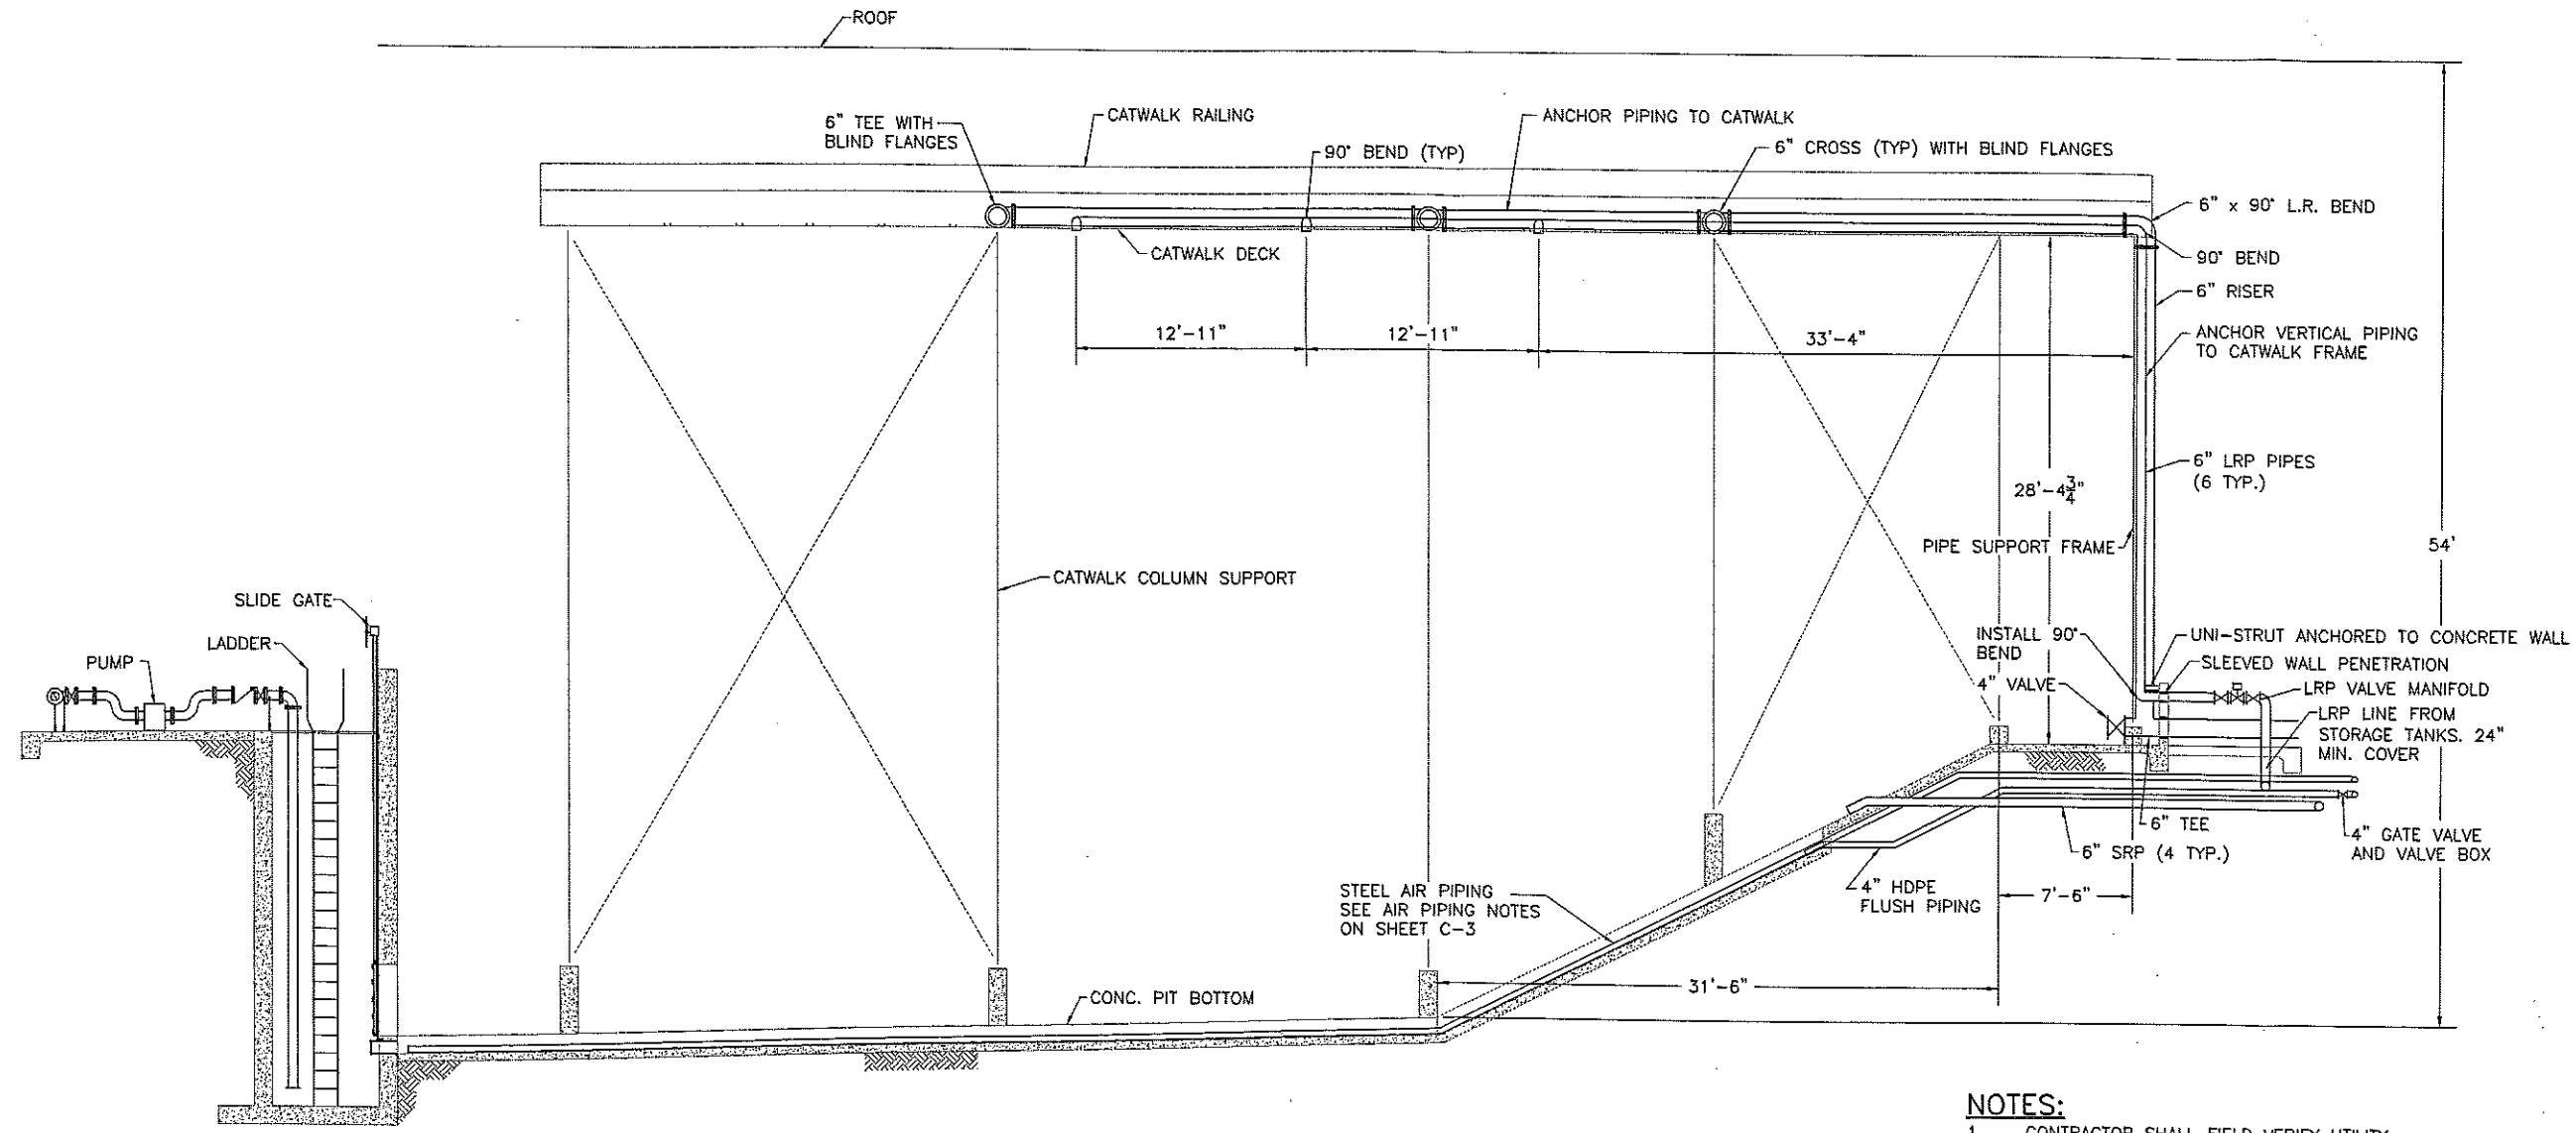

CROSS SECTION VIEW
 A
 P-1/P-4
 0 4' 8'
 3/16" = 1'-0"

NOTES:
 1. CONTRACTOR SHALL FIELD VERIFY UTILITY ELEVATIONS TO AVOID CONFLICTS.

This Record Drawing is a combination of the original drawings and any changes made to this project, modified by information furnished by the contractor reflecting changes in the Project made during construction. The original drawings are the responsibility of the original drafter and are not to be used for any other project without the written consent of FREESE AND NICHOLS, INC.
 4855 INTERNATIONAL BLVD. SUITE 200,
 FORT WORTH, TEXAS 76109-4855
 (817) 735-7300
 RECORD DRAWING PREPARED ON:
 8/25/2009

FREESE AND NICHOLS
 4040 Broadway Street, Suite 600
 San Antonio, Texas 78209-6350
 Tel = (214) 238-3900
 Fax = (214) 238-3901
 Joly New 11-16-09

TERRABON, LLC
MIX ALCO BIOMASS PILOSTRATION FACILITY
PLANT FACILITY
LONGITUDINAL SECTION

NO.	ISSUE	BY	DATE	REV	DESCRIPTION
TRB07370	DATE	TRB07370	MAY 2008	DESIGNED	TEV
				DRAWN	CTP
				REVISED	C.E./CTP
				CHECKED	TEV
				FILE NAME	CV-TRB-DT-MISC02.dwg

Bar is one inch on original drawing. If not one inch on this sheet, adjust scale.

VERIFY SCALE
 0

SHEET **P-4**
 SEQ.