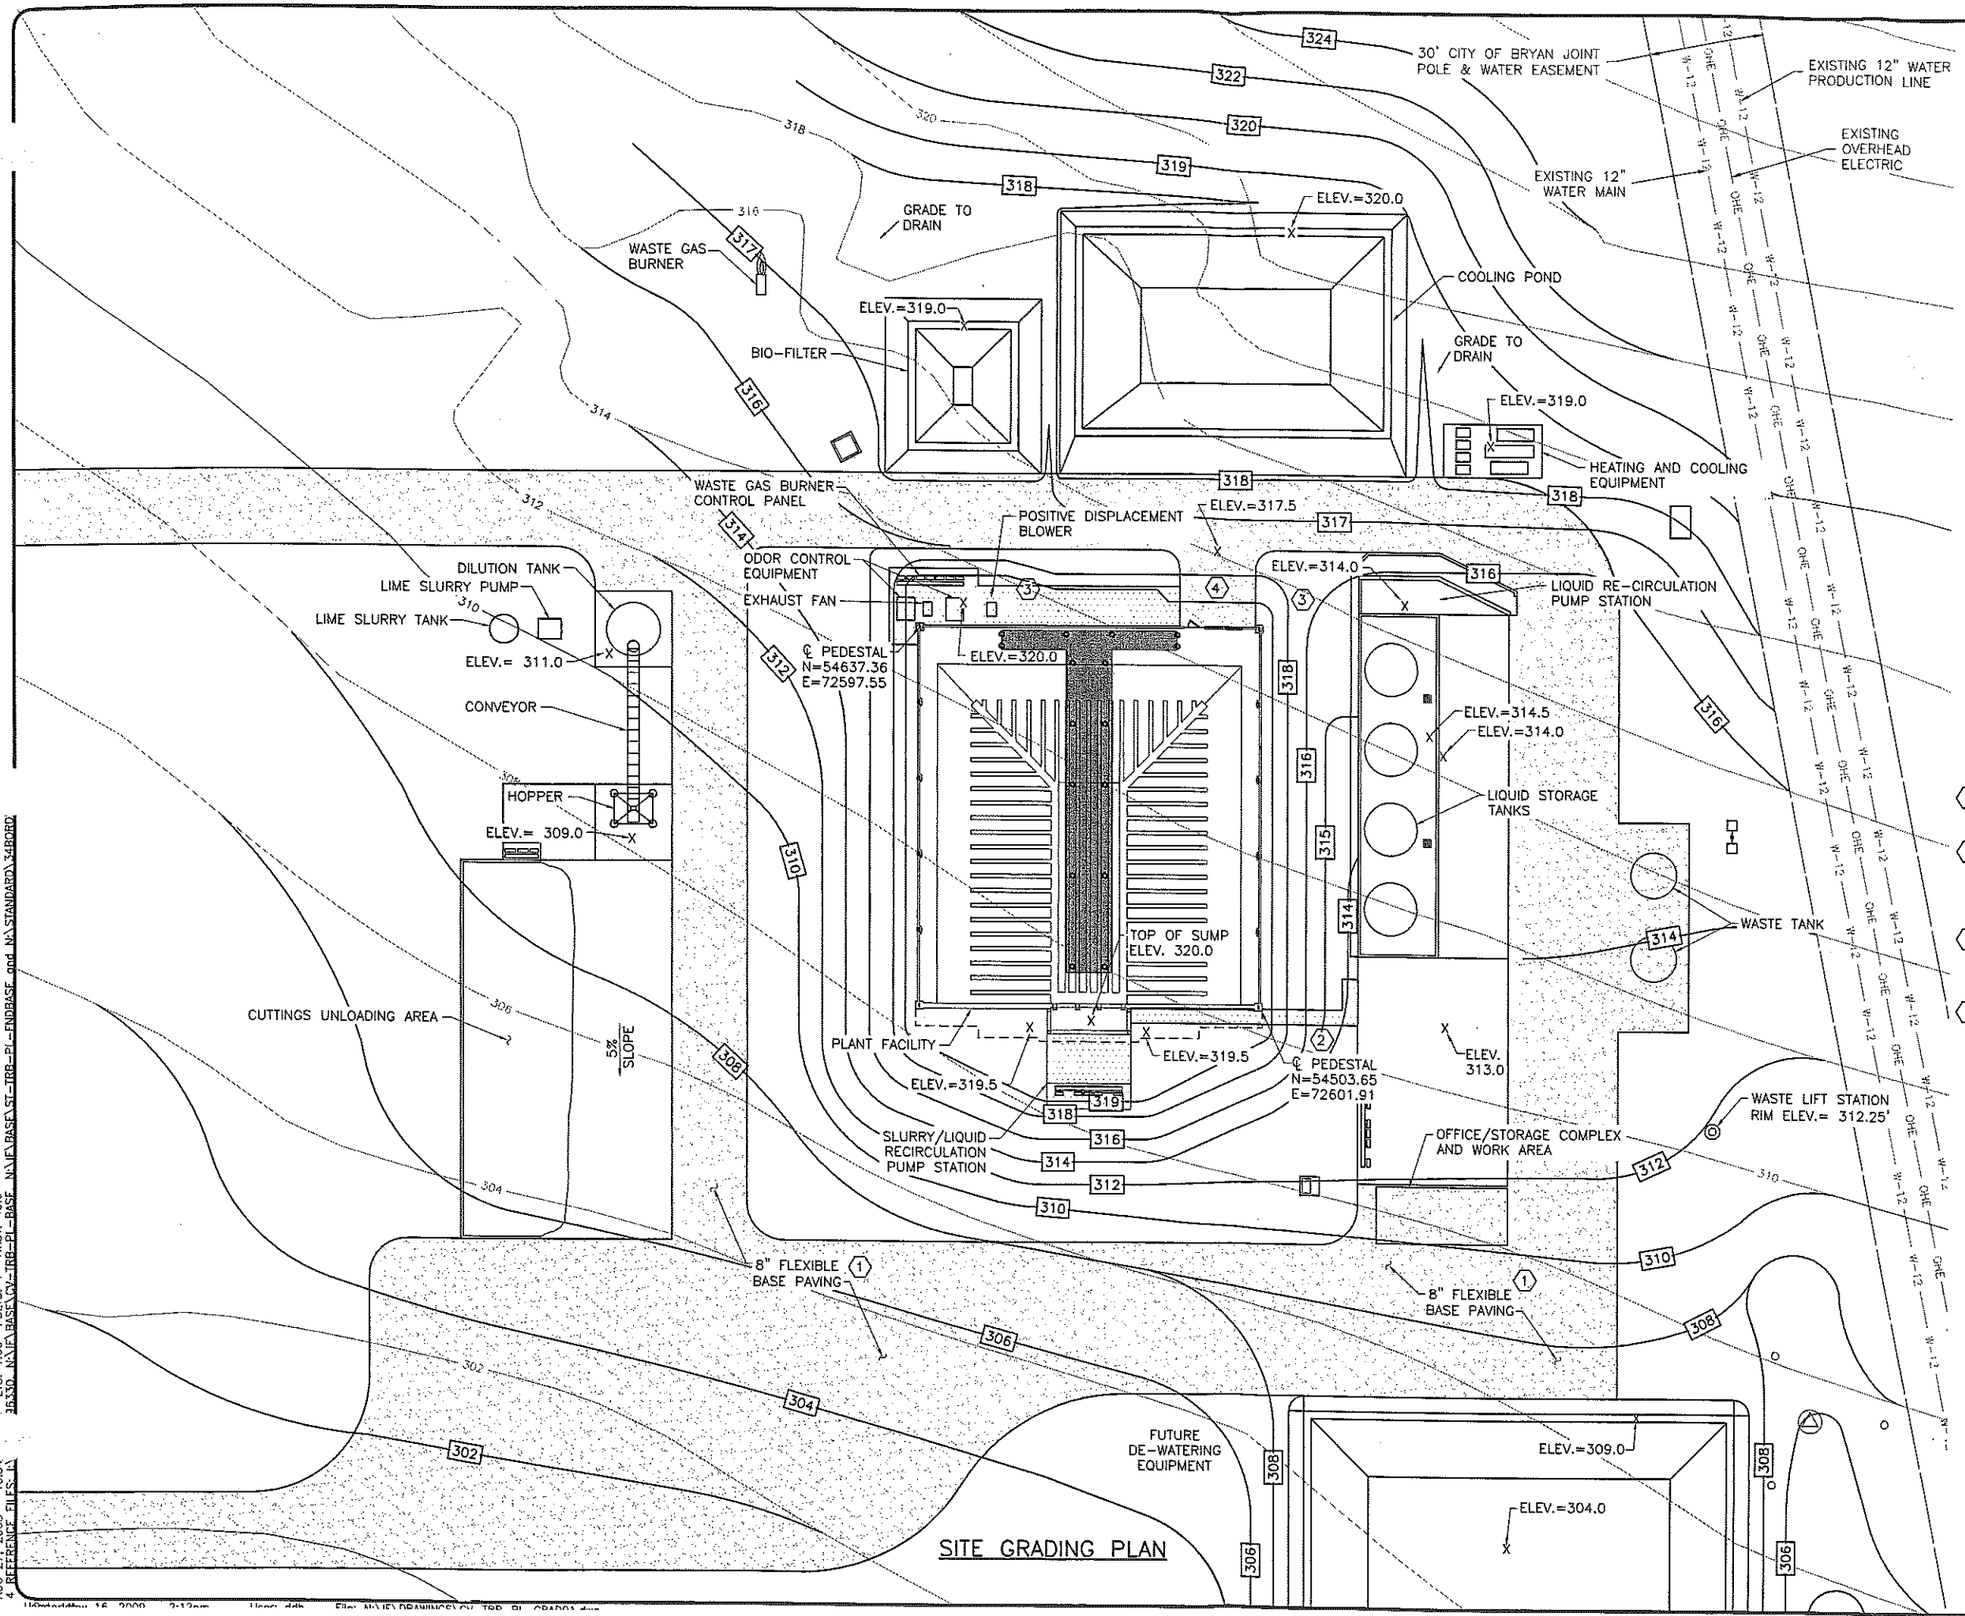

This Record Drawing is a combination of the sealed engineering contract drawings for this project, modified by information furnished by subcontractors, vendors, and others in the Project made during construction. The original sealed drawings are on file at the offices of FREESE AND NICHOLS, INC.
4055 INTERNATIONAL PLAZA, SUITE 200
FORT WORTH, TEXAS 76109-4895
(817) 735-7300
RECORD DRAWINGS PREPARED ON: 9/5/2009

N PLAN NORTH

0 10' 20' 40'
SCALE IN FEET

LEGEND:

—320—	PROPOSED GRADING
—320—	EXISTING CONTOURS

NOTES:

1. CONTRACTOR SHALL GRADE SITE TO DRAIN AND TO FACILITATE ACCESS TO DOORS, PUMPS, AND ELECTRICAL EQUIPMENT. ALL SLOPES SHALL BE EASILY MAINTAINED AND MOWED.
2. ALL AREAS TO RECEIVE SLABS, PADS, PAVING, SIDEWALK OR ANY OTHER STRUCTURAL ELEMENT SHALL HAVE MINIMUM 6" OF TOPSOIL REMOVED AND COMPACTED TO 95% STANDARD PROCTOR UNLESS NOTED OTHERWISE.

NOTES BY SYMBOL "⬡"

1 FLEXBILE BASE TO BE TxDOT 340 A2 BASE COMPACTED TO 95% STANDARD PROCTOR.

2 4' WIDE x 4" THICK CONCRETE SIDEWALK. PROVIDE TWO 5' LONG EVENLY SPACED LEVEL SECTIONS. SURFACE TO BE ROUGH NON-SLIP FINISH.

3 SIDWALK CONSTRUCTED SAME AS THAT IN NOTE BY SYMBOL 2 WITHOUT THE 5' LEVEL SECTIONS.

4 6" THICK CONCRETE RAMP 20' WIDE WITH #4 AT 12" O.C.E.W. ON 8" OF FLEX BASE COMPACTED TO 95% STANDARD PROCTOR.

STATE OF TEXAS
JOHNNY M. NEW
96330
LICENSED
PROFESSIONAL ENGINEER
11-16-09

FREESE AND NICHOLS
4040 Broadway Street, Suite 600
San Antonio, Texas 78209-5350
Phone – (210) 298-3300
Fax – (210) 298-3301

TERRABON, LLC
MIX ALCO BIOMASS PILOSTRATION FACILITY
SITE GRADING PLAN – NORTH

NO.	ISSUE	BY	DATE

FILE NAME CV-TRB-PL-GRAD01.dwg
CHECKED
REVISED
DRAWN DDH
DESIGNED JMN
DATE MAY 2008
FSN JOB NO. TRB07370

VERIFY SCALE Bar is one inch on original drawing. If not one inch on this sheet, adjust scale.

SHEET C-2
SEQ.

ACAD Ref: 1/2s (LMS Tech) User: DDH
[TRB07370][CORPUS]N:\VF\DRAWINGS\CV-TRB-PL-GRAD01.DWG LAYOUT: Layout1
AUG 27, 2008 10:34 LTS: 1.00 PSLTS: 1 TWIST: 40.0
4 REFERENCE FILES: N:\VF\BASE\CV-TRB-PL-BASE N:\VF\BASE\ST-TRB-PL-ENDBASE and N:\STANDARD\34BORD